



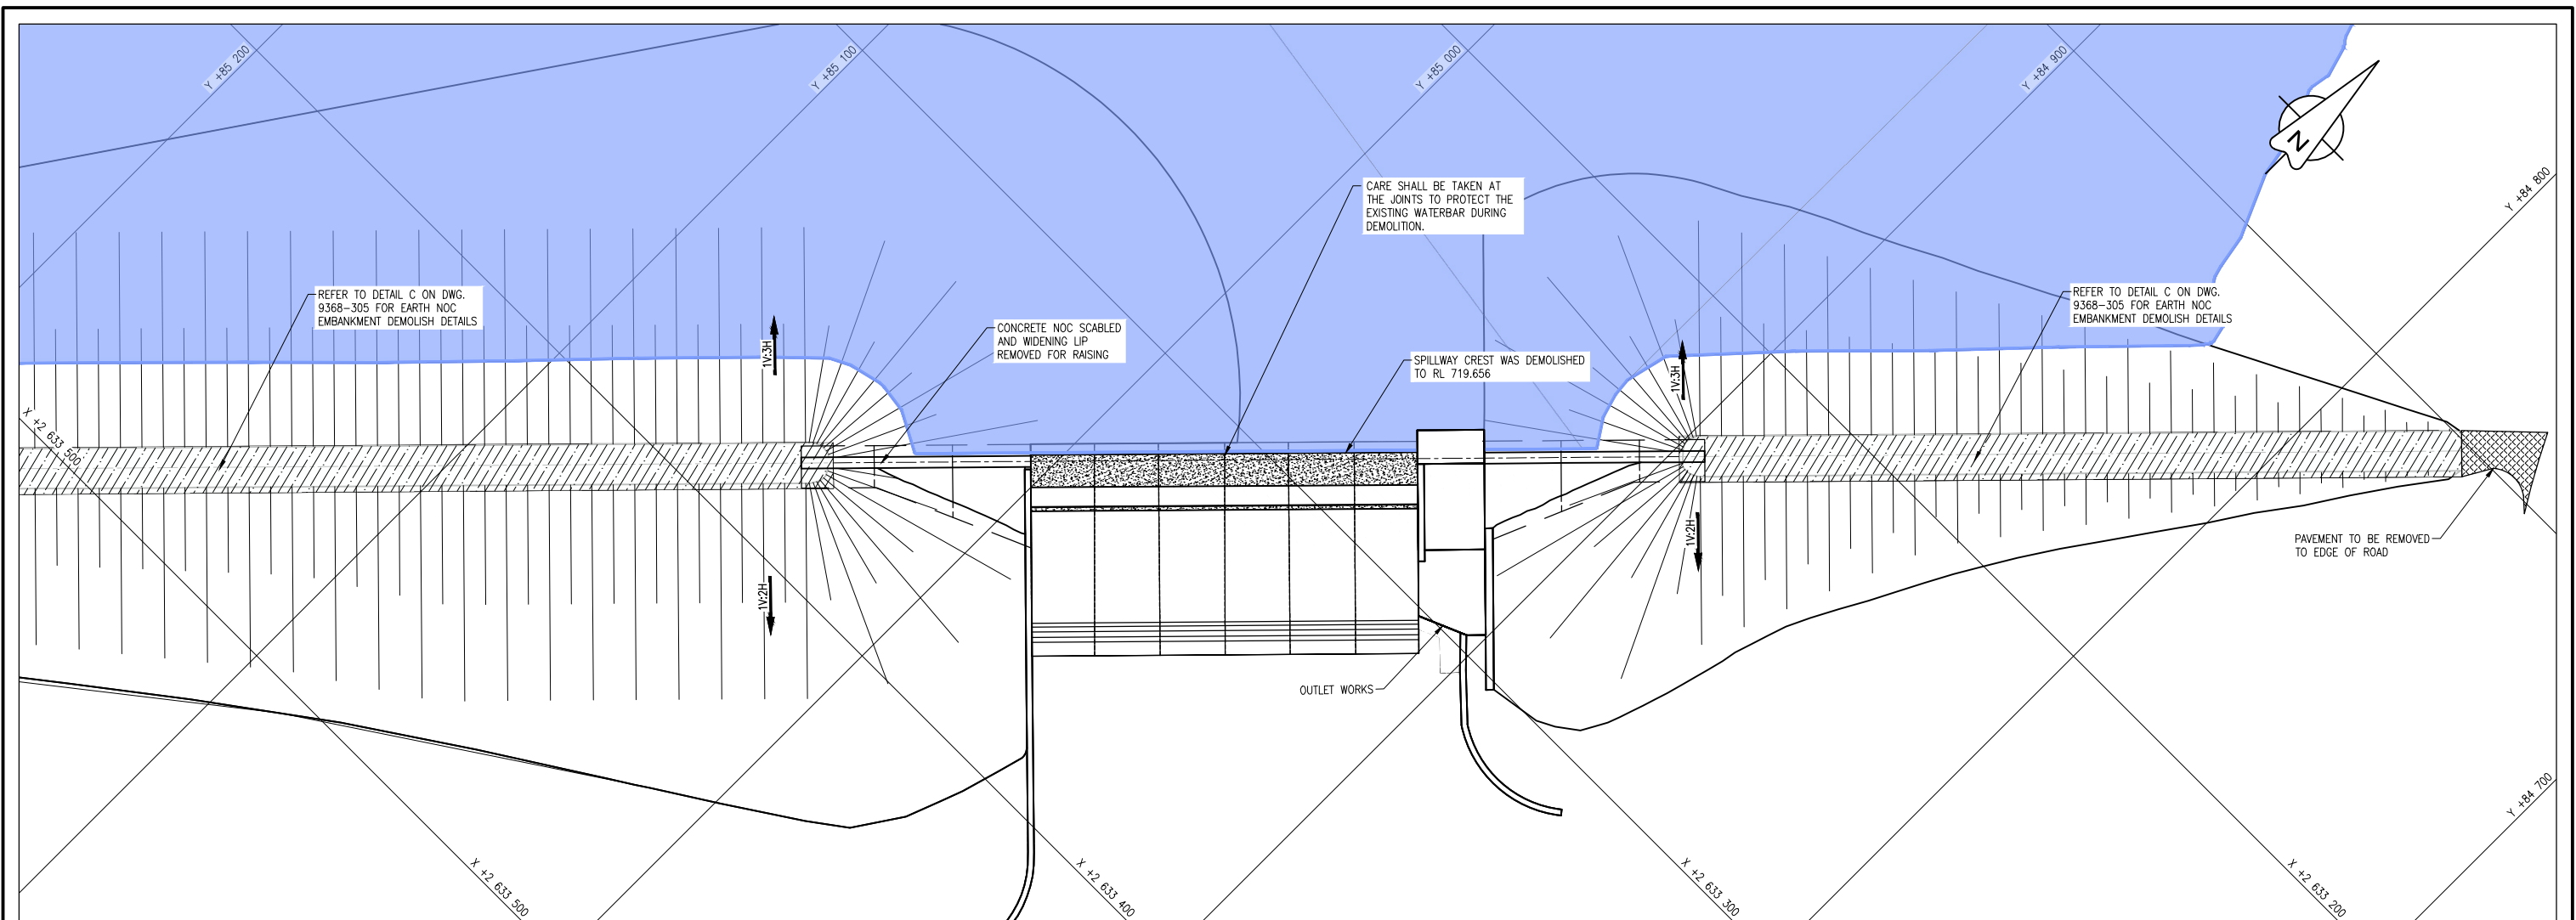

SPILLWAY DEMOLITION

SCALE 1:750

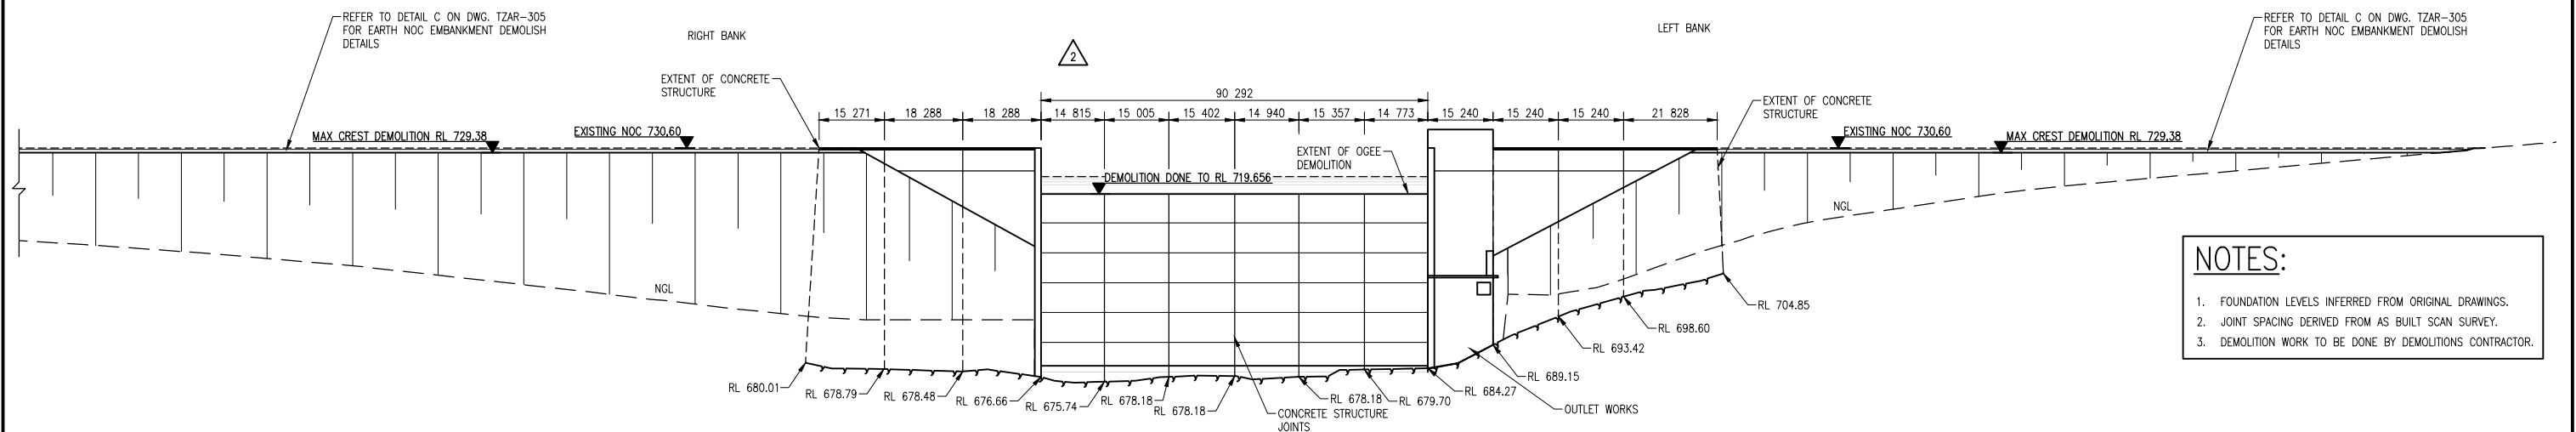

DOWNSTREAM ELEVATION INDICATING CREST DEMOLITION

SCALE 1:750

- NOTES:**
- FOUNDATION LEVELS INFERRED FROM ORIGINAL DRAWINGS.
 - JOINT SPACING DERIVED FROM AS BUILT SCAN SURVEY.
 - DEMOLITION WORK TO BE DONE BY DEMOLITIONS CONTRACTOR.

3/3	SECTIONS AND DETAILS 2	9368-305	X
2/3	SECTIONS AND DETAILS 1	9368-304	X
1/1	LIST OF DRAWINGS	9368-015	X
SHEET	DESCRIPTION	OTHER No.	REG. No.
LIST OF DRAWINGS			

SCALE 1:750

0 5 10 15 20 25 35 45 55 65 75 150 m

PREPARED BY:	REVISION	FOR	DWS	DEPARTMENT OF WATER AND SANITATION REPUBLIC OF SOUTH AFRICA	GROOT LETABA RIVER WATER DEVELOPMENT PROJECT (GLeWaP)			
ARQ CONSULTING ENGINEERS	MOD No. DATE DESCRIPTION	FOR	DWS	HEAD OFFICE ENGINEERING SERVICES PRIVATE BAG X313 PRETORIA 0001	SEDIBENG BUILDING 185 FRANCIS BAARD STREET PRETORIA (012) 336-7500	TZANEEN DAM RAISING		
	01 06/23 ISSUE FOR CONSTRUCTION	QS		D.M. MASHITSHO DIRECTOR GENERAL		SPILLWAY RISING		
	02 06/26 DEMOLITIO LEVEL UPDATED	QS		M BLAESER	DESIGN: HJ WRIGHT	DEMOLITIONS - PLAN LAYOUT AND ELEVATION		
				CHECKED: HJ WRIGHT	DATE: NM	PROVINCE: LIMPOPO	DISTRICT: TZANEEN	KEYCODES: - - - - -
				ENGINEER: Q SHAW	DATE: EXT. APPROVAL / DESIGN CHECKED: DATE:	LOCALITY No.: -	TENDER/CONTRACT No.: -	OTHER NUMBER 9368-303
				CHIEF ENGINEER / APP (Pr. Eng):	DATE: DIRECTOR (Pr. Eng):	SHEET 1 of 3	REV. X	92